


OFFICIAL SURVEY
OTOE COUNTY, NEBRASKA
TIES TO INTERSECTION ON WASHINGTON STREET IN VILLAGE OF DOUGLAS,
OTOE COUNTY, NEBRASKA

2008-14

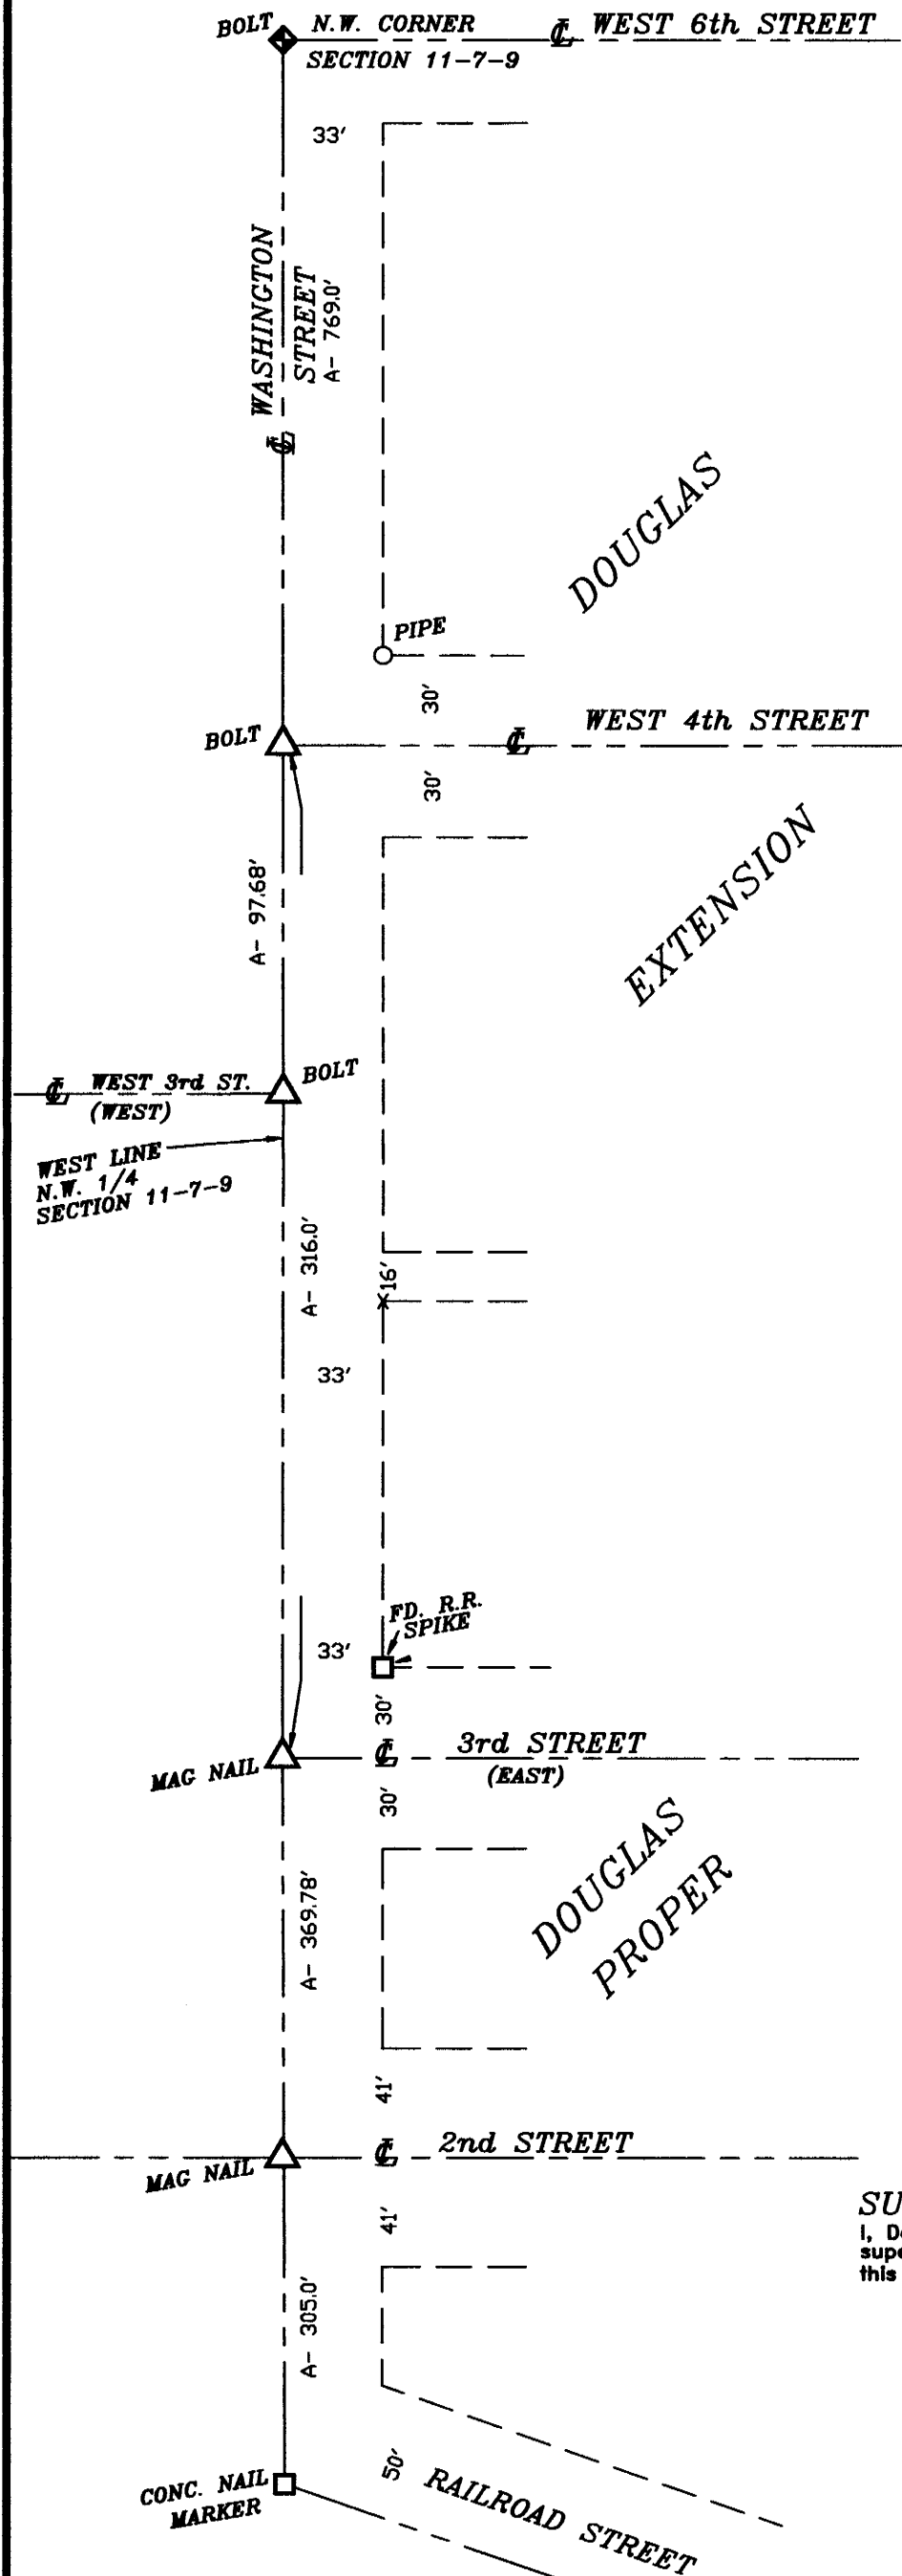

N

SCALE: NONE

○ □ FOUND CORNER
△ ◆ FOUND INTERSECTION POINT
A- ACTUAL DISTANCE
P- PLAT DISTANCE
0 revisions

N.W. CORNER SECTION 11-7-9
FOUND BOLT
S.W. 41.57' TO NAIL & BOTTLE CAP IN P.P.
S.E. 47.87' TO SPIKE IN POLE
N.E. 40.36' TO SPIKE STEP IN P.P.
N.W. 9.67' TO MANHOLE
S.E. 46.88' TO BAR & CAP
N.W. 48.47' TO NEAR EDGE R.O.W. MARKER

WEST 4th STREET & WASHINGTON
FOUND BOLT
N.E. 42.32' TO FIRE HYDRANT
N.E. 45.69' TO PIPE (block corner)
N.W. 71.77' TO NAIL/PLASTIC IN P.P.
S.W. 33.31' TO NAIL/PLASTIC IN P.P.
S.E. 77.85' TO N.W. CORNER HOUSE

WEST 3rd STREET (West) & WASHINGTON
FOUND BOLT
S.W. 57.92' TO NAIL/BOTTLE CAP IN P. POLE
E.S.E. 38.24' TO 20d NAIL IN 26" MAPLE
E.N.E. 40.25' TO 20d NAIL IN 36" MAPLE
N.W. 53.21' TO 20d NAIL IN 24" ELM

WEST 3rd STREET (East) & WASHINGTON
FOUND MAG NAIL
S.W. 10.98' TO M. HOLE
S.W. 29.45' TO NAIL & BOTTLE CAP IN P.P.
S.E. 63.02' TO S.W. CORNER METHODIST CHURCH SIGN
N.E. 44.60' TO R.R. SPIKE (block corner)
N.E. 22.95' TO WATER VALVE
N.W. 56.18' TO NAIL/PLASTIC IN P.P.
N.E. 44.90' TO WATER VALVE

2nd STREET & WASHINGTON
FOUND MAG NAIL
N.E. 25.45' TO WATER VALVE
S.W. 1.6' TO MANHOLE
S.W. 24.58' TO NAIL/BOTTLE CAP IN P. POLE
E.S.E. 79.91' TO NAIL/BOTTLE CAP IN P. POLE
N.E. 52.5' TO 1/2" BAR & CAP
N.E. 53.24' TO WATER VALVE

SOUTH LINE RAILROAD STREET & WASHINGTON
FOUND CONCRETE NAIL MARKER
N.W. 42.7' TO NAIL/CAP IN P. POLE
N.E. 55.7' TO WEST BOLT BOTTOM FLANGE FIRE HYDRANT
N.E. 49.34' TO BOTTOM OF ANCHOR

SURVEY RECORD REPOSITORY
RECEIVED
OCT 03 2003
\$ NC
County OTOE

882-161

SURVEYOR'S CERTIFICATE

I, David L. Schmitz, OTOE COUNTY SURVEYOR, hereby certify that under my personal supervision, this ties to intersection plat was prepared from an actual survey completed this 7th day of August 2008, and is correct to the best of my knowledge.



David L. Schmitz, REGIST. LAND SURVEYOR
Nebraska Reg. No. 391
Otoe County Surveyor